




A CORNER REINFORCEMENT DETAILS
S4.1 SCALE: 1" = 1'-0"

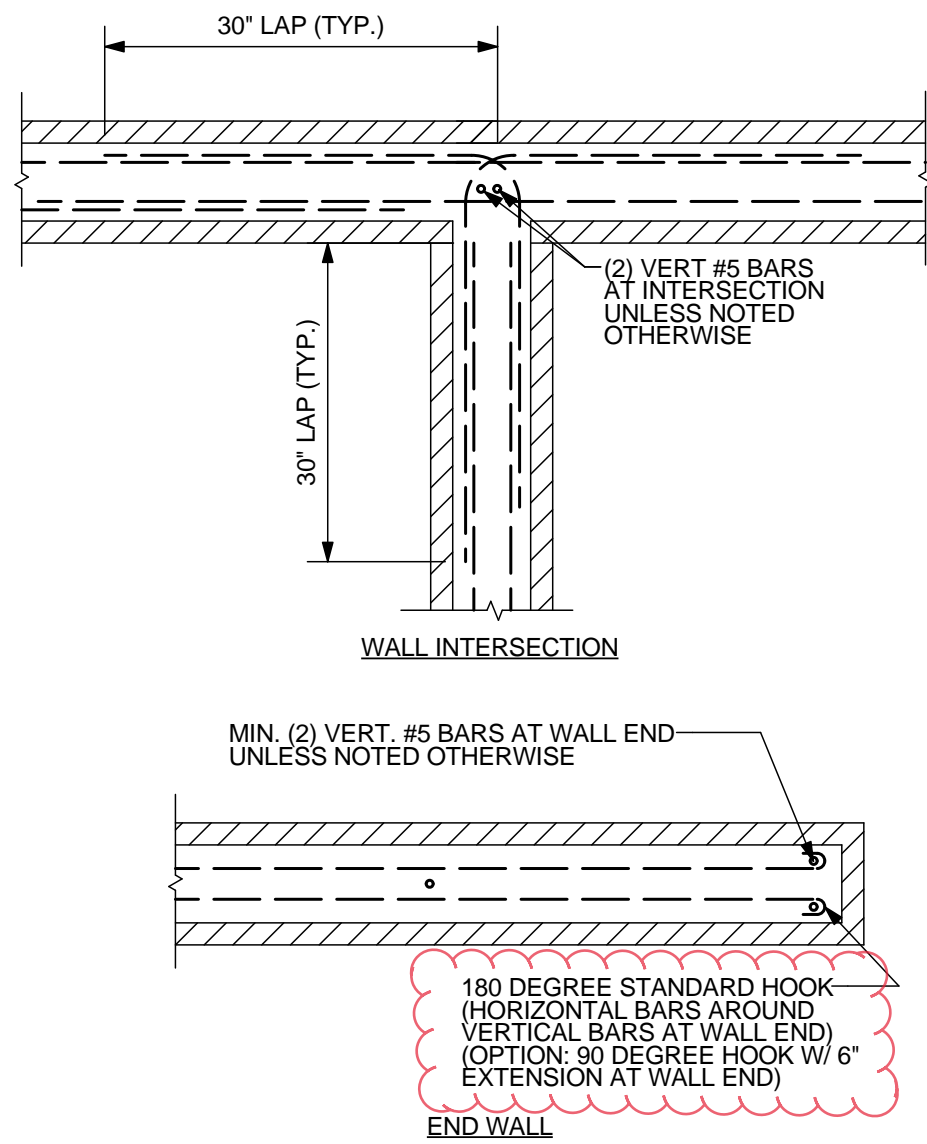


B END WALL AND INTERSECTION MASONRY DETAILS
S4.1 SCALE: 1" = 1'-0"

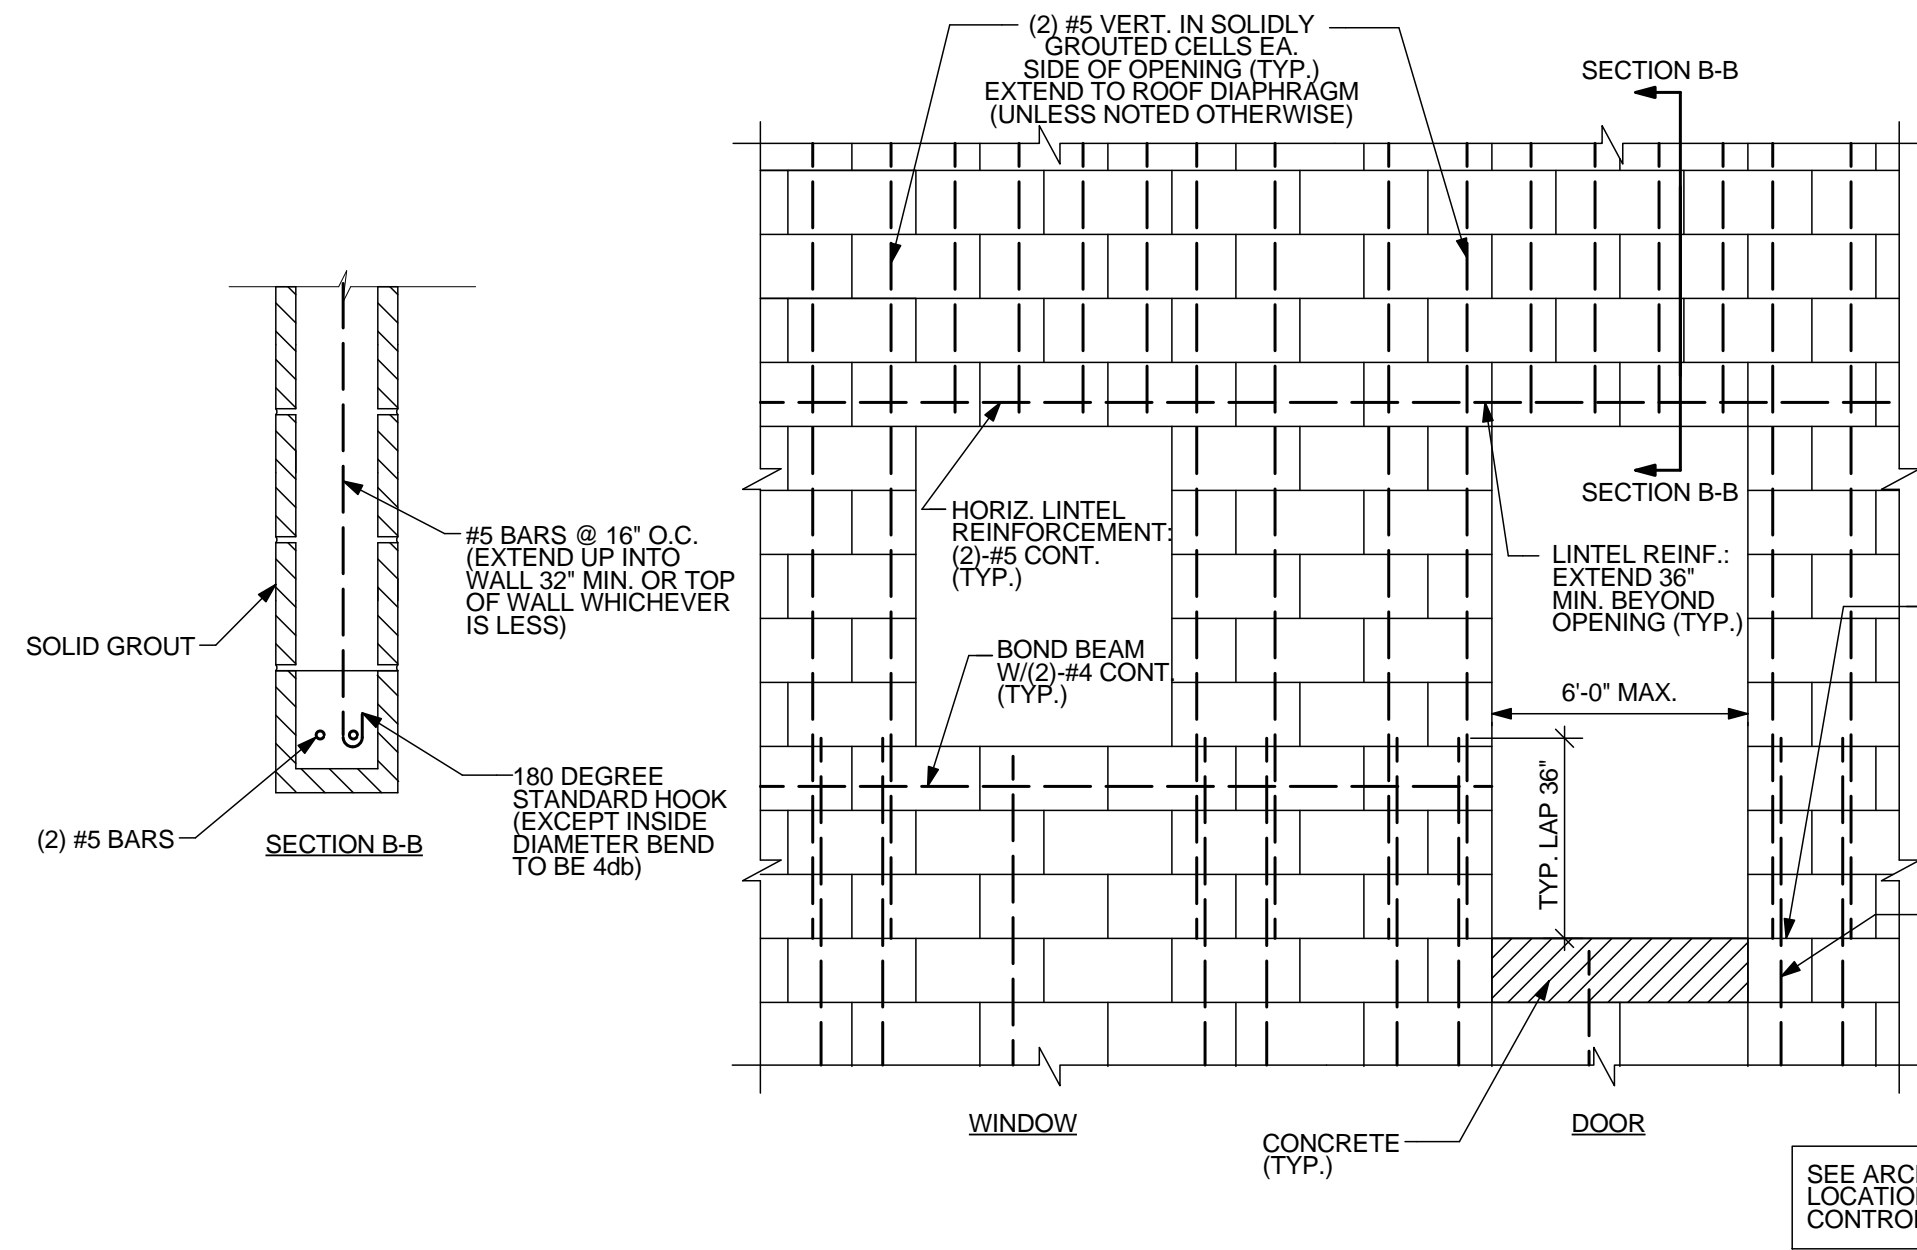


C OPENING AND CONTROL JOINT DETAILS
S4.1 NOT TO SCALE

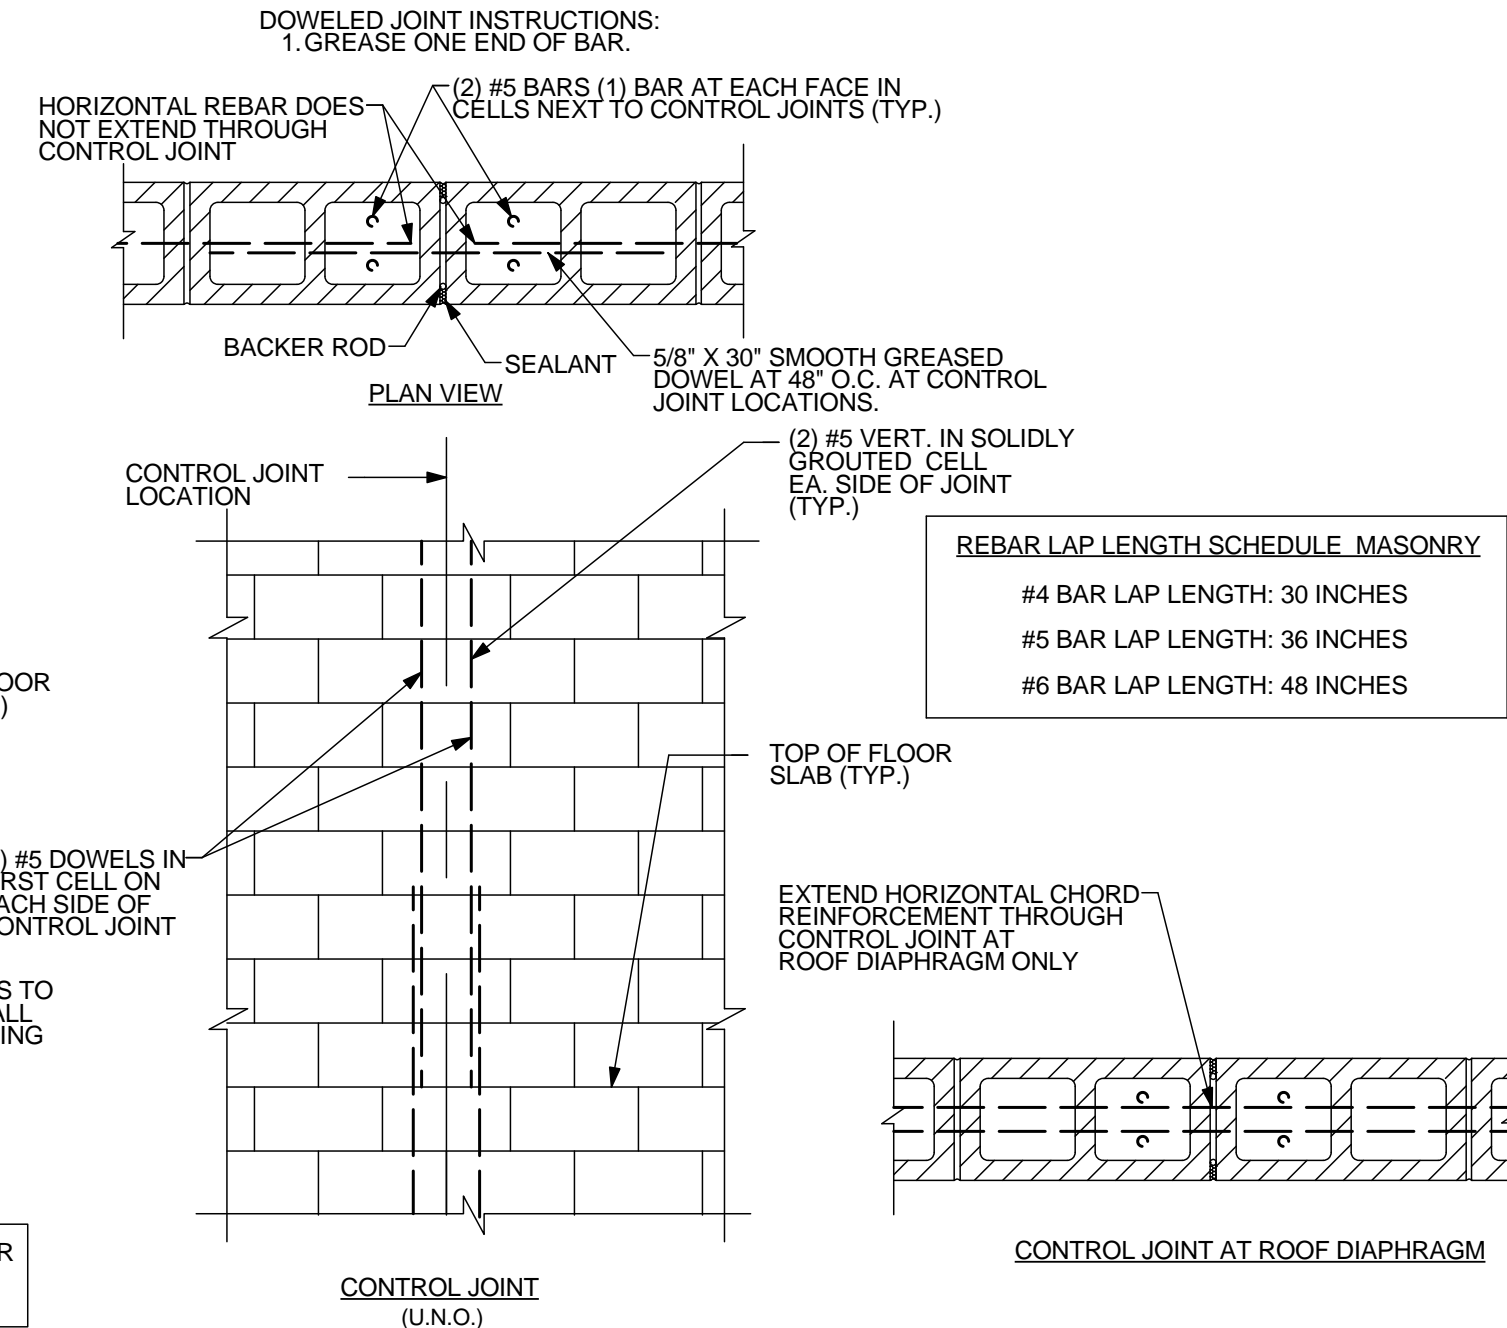


REBAR LAP LENGTH SCHEDULE MASONRY	
#4 BAR LAP LENGTH:	30 INCHES
#5 BAR LAP LENGTH:	36 INCHES
#6 BAR LAP LENGTH:	48 INCHES

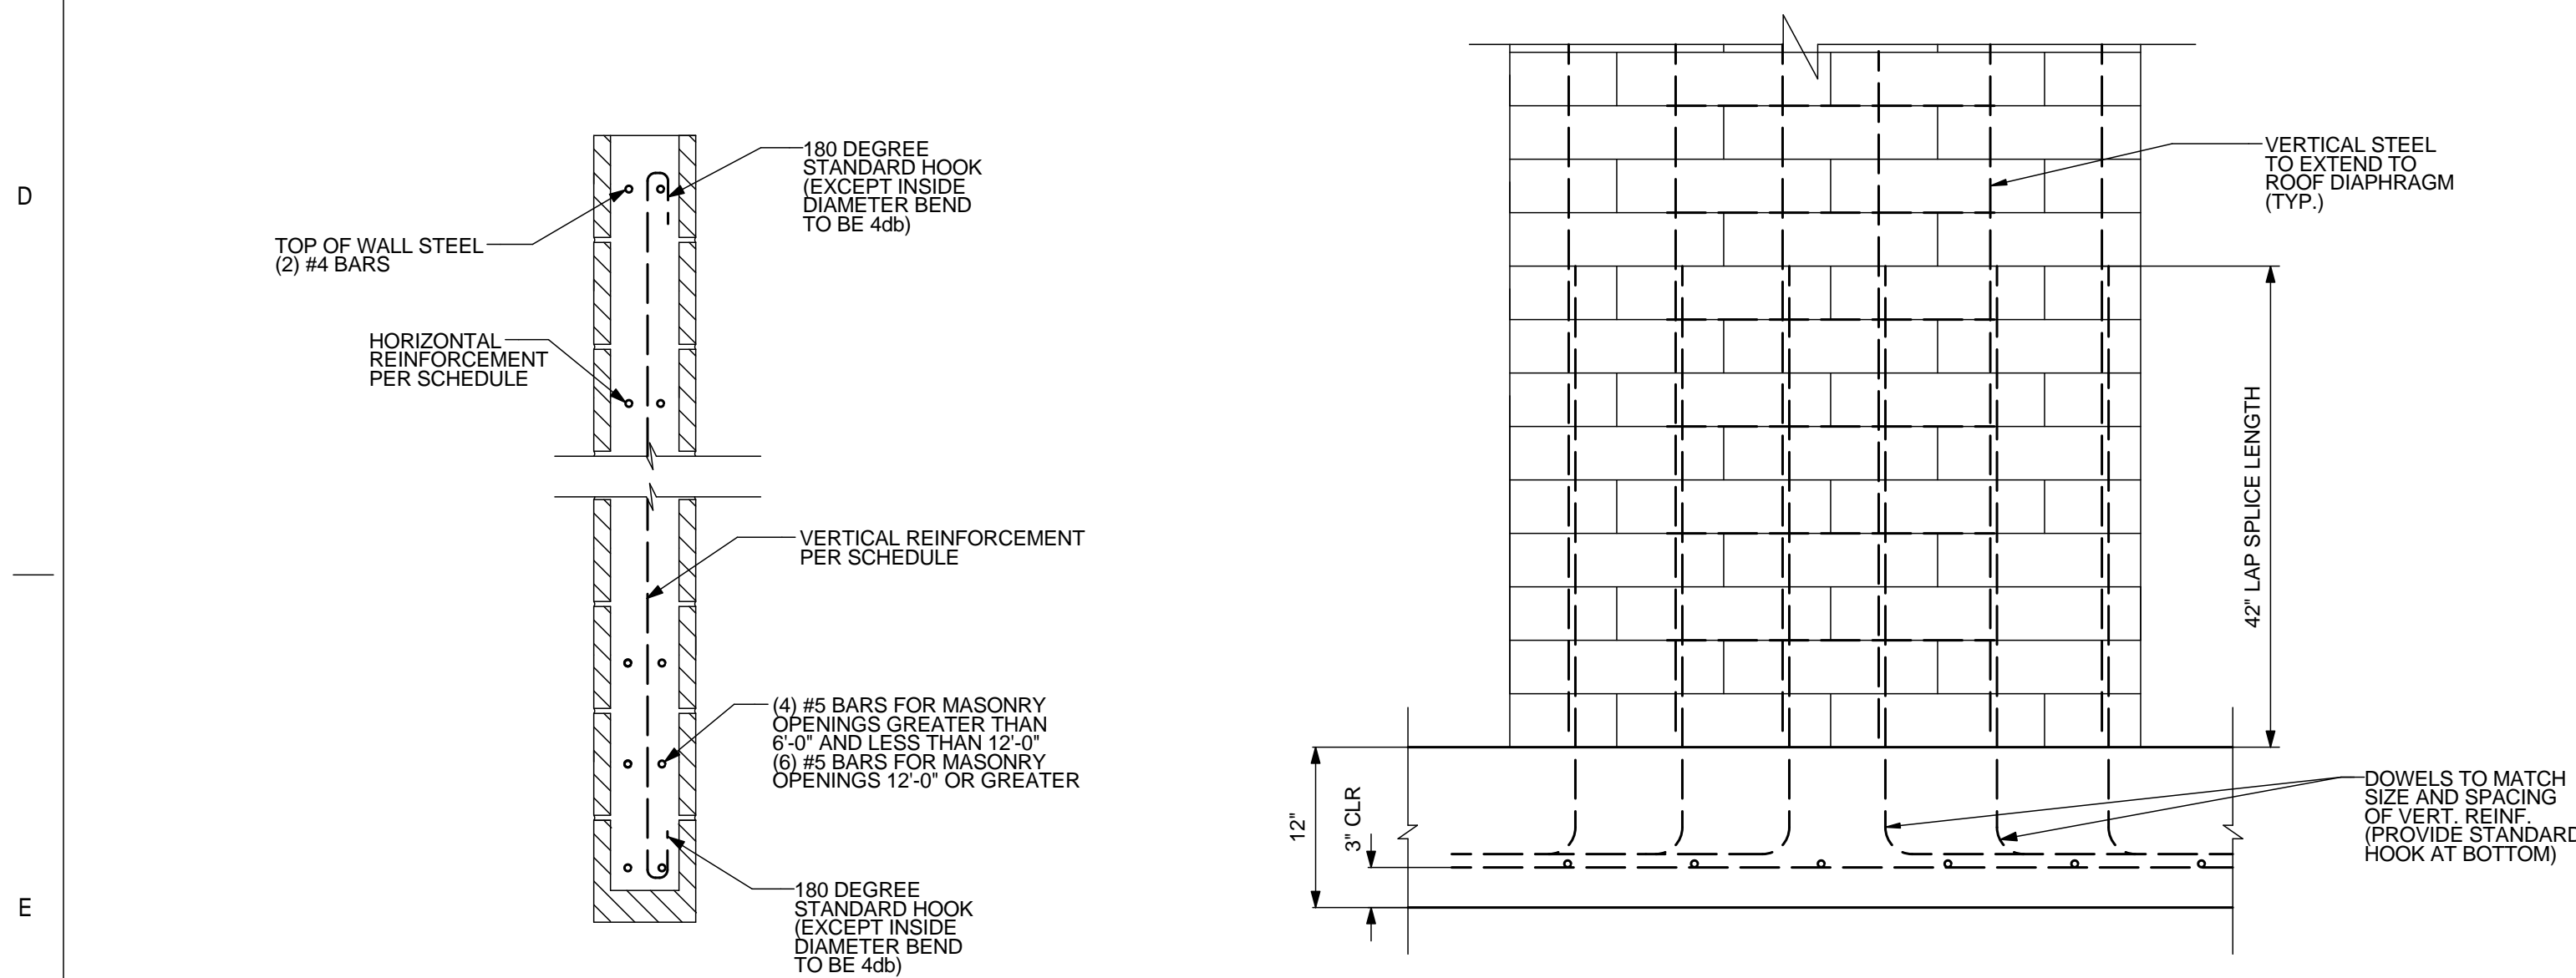


D SPECIAL LINTEL DETAIL
S4.1 NOT TO SCALE

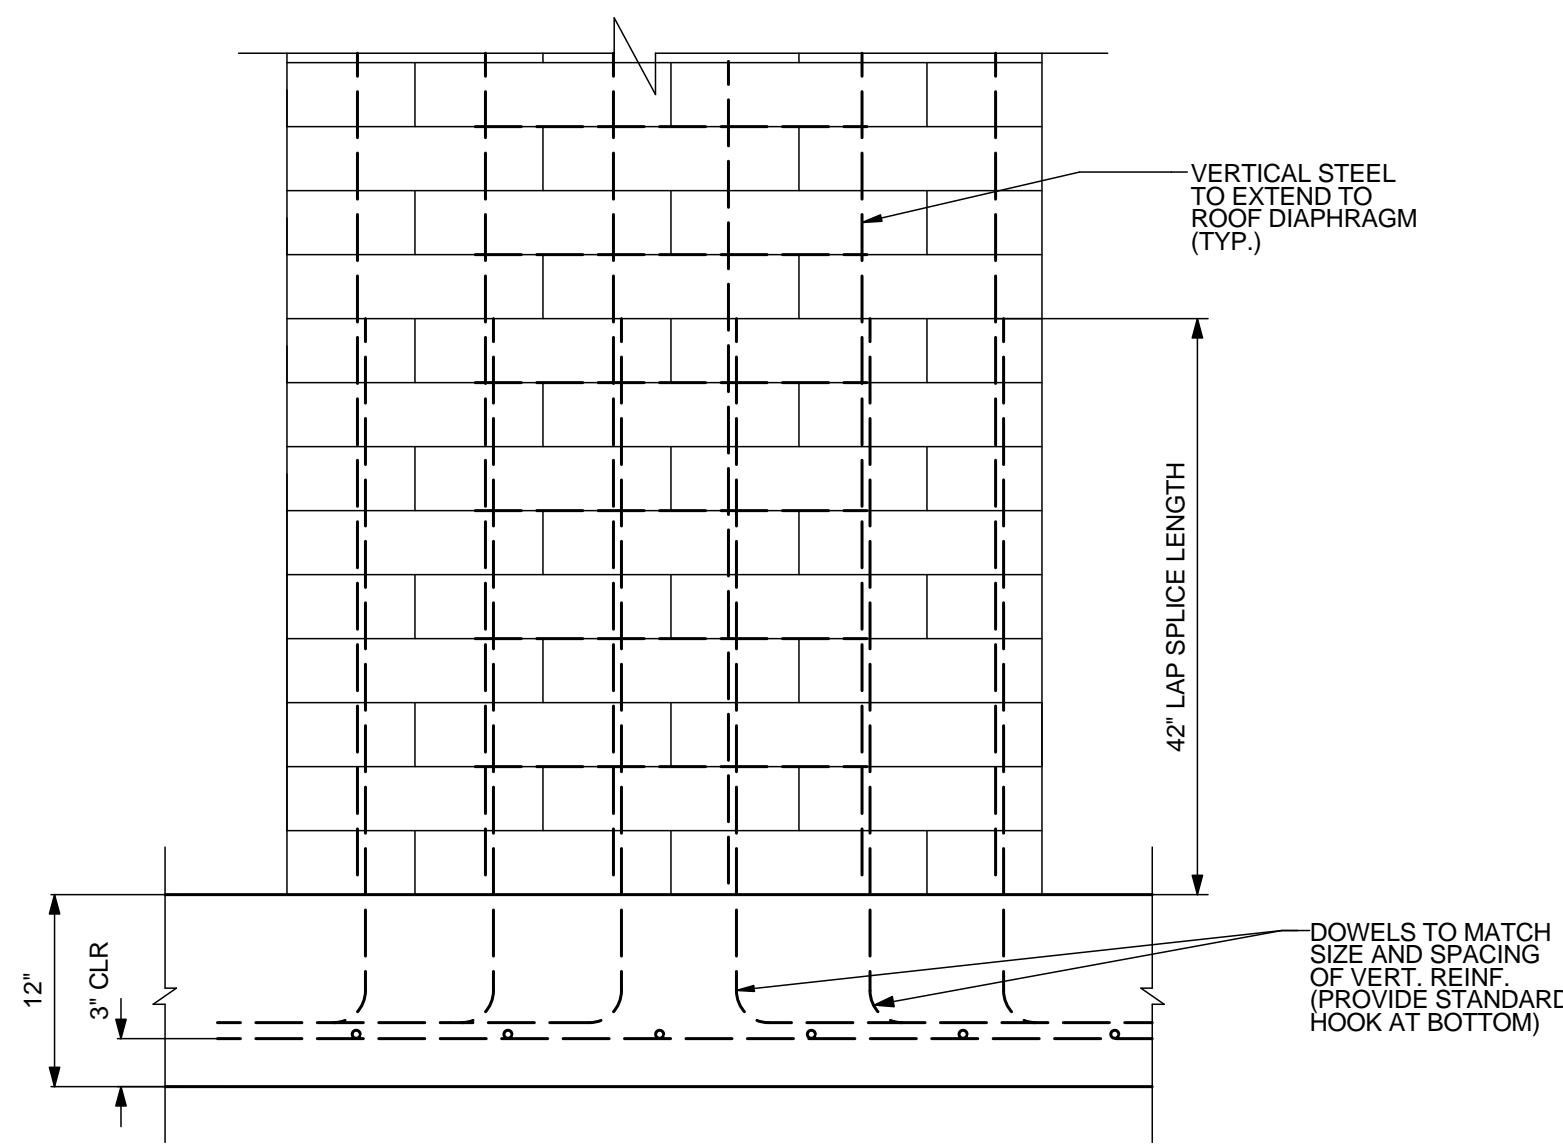


E PILASTER DETAIL
S4.1 SCALE: 1" = 1'-0"

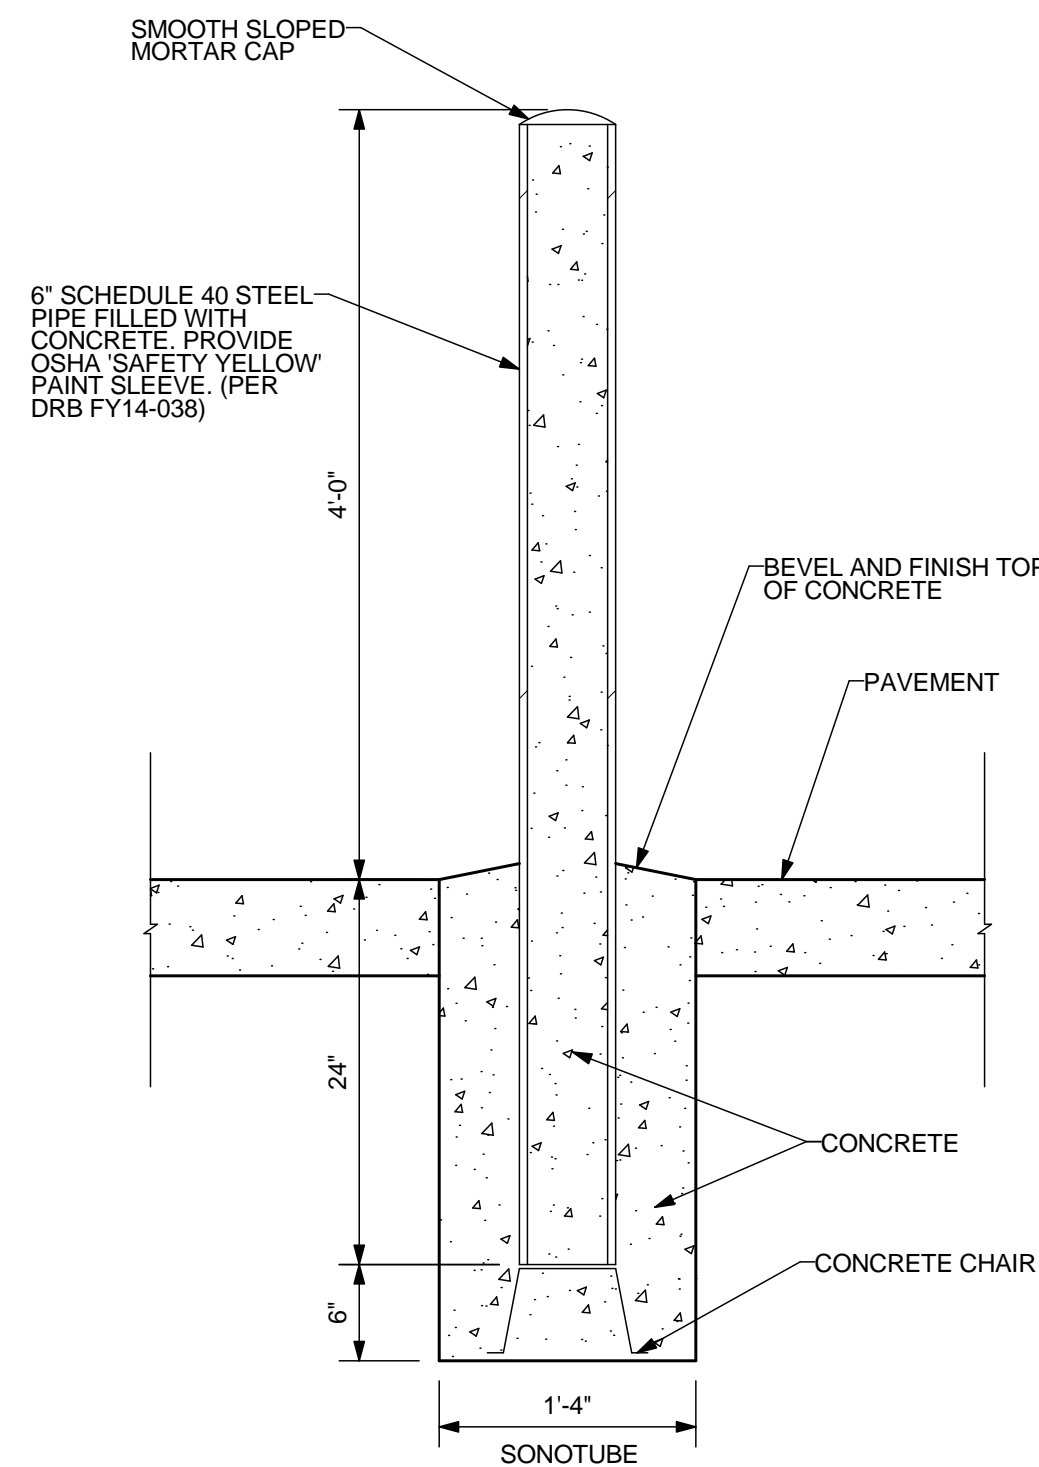

F 6" DIAMETER BOLLARD DETAIL
S4.1 SCALE: 1" = 1'-0"

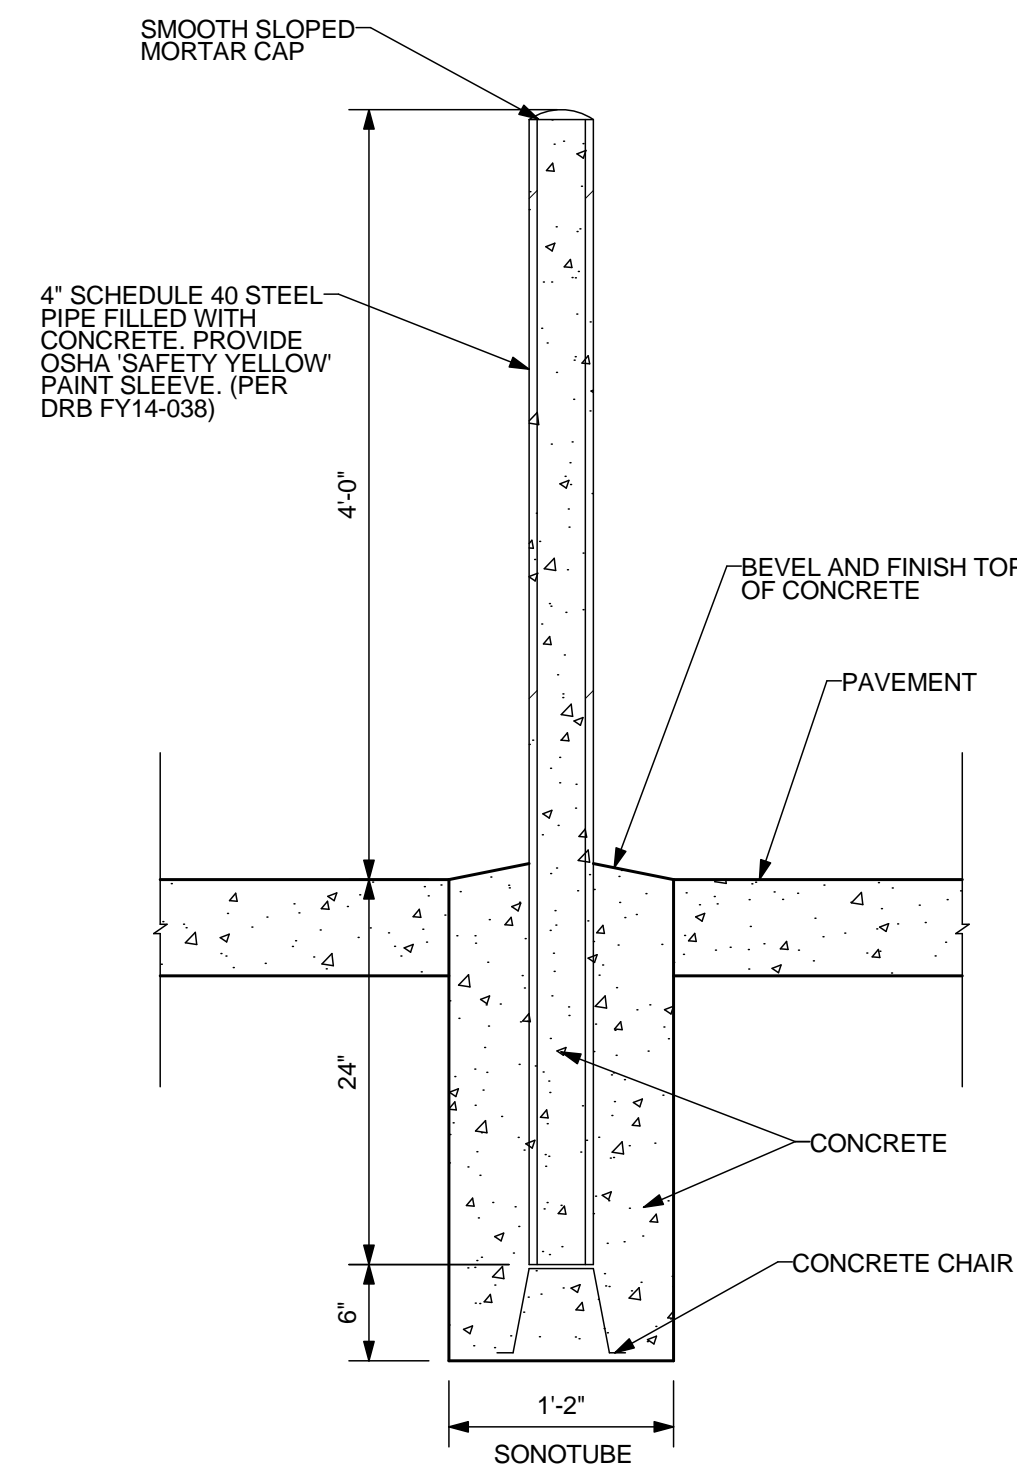

G 4" DIAMETER BOLLARD DETAIL
S4.1 SCALE: 1" = 1'-0"

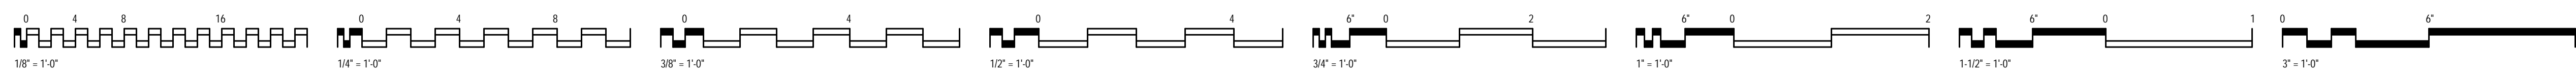

WILCO EUGENE

11TH & WILLOW CREEK
EUGENE, OREGON 97402

WILCO

200 INDUSTRIAL WAY
MT. ANGEL, OR 97132

project number 22-0690
date 12/19/2022

revisions
2 - plan review 05/15/2023

STABILITY ENGINEERING INC.
777 NE 2ND ST. SUITE 280
P.O. BOX 2646
CORVALLIS, OR 97339
TEL.: (541)223-5360



STRUCTURAL DETAILS

sheet number

S4.1