

DOOR SCHEDULE

SEE PROJECT MANUAL FOR HARDWARE TYPES

NO.	ROOM	TYPE	SIZE			DOOR				FRAME		NOTES:
			WIDTH	HEIGHT	THK.	HARDWARE TYPE	MATERIAL	GLASS	FINISH	MATERIAL	FINISH	
101A	VESTIBULE	8	8'-0"	7'-6"	1 3/4"	A	ALUM	TEMP	FACTORY	ALUM	FACTORY	
101B	VESTIBULE	8	8'-0"	7'-6"	1 3/4"	A	ALUM	TEMP	FACTORY	ALUM	FACTORY	
102A	SALES	6	14'-0"	7'-6"	1 3/4"	A	ALUM	TEMP	FACTORY	ALUM	FACTORY	
102B	SALES TO GARDEN	7	7'-4"	7'-6"	1 3/4"	A	ALUM	TEMP	FACTORY	ALUM	FACTORY	
102C	SALES	3	6'-0"	8'-0"	1 3/4"	MFR	STEEL	TEMP	PAINT	HM	PAINT	4
104A	WAREHOUSE	10	6'-0"	7'-0"	1 3/4"	E	STEEL	-	PAINT	HM	PAINT	5, 8 1
104B	WAREHOUSE	9	3'-0"	7'-0"	1 3/4"	E	STEEL	-	PAINT	HM	PAINT	5, 8
104C	WAREHOUSE	11	12'-0"	12'-0"	1 3/4"	-	STEEL	-	PAINT	HM	PAINT	1
104D	WAREHOUSE	9	3'-0"	7'-0"	1 3/4"	E	STEEL	-	PAINT	HM	PAINT	8 1
104E	WAREHOUSE	11	12'-0"	12'-0"	1 3/4"	-	STEEL	-	PAINT	HM	PAINT	
104F	WAREHOUSE	11	12'-0"	12'-0"	1 3/4"	-	STEEL	-	PAINT	HM	PAINT	1
104G	WAREHOUSE	9	3'-0"	7'-0"	1 3/4"	E-1	STEEL	-	PAINT	HM	PAINT	5, 8 1
105	GROOMING	2	3'-0"	7'-0"	1 3/4"	B	STEEL	TEMP	PAINT	HM	PAINT	
106	SELF-SERVE DOG BATHING	2	3'-0"	7'-0"	1 3/4"	C	STEEL	TEMP	PAINT	HM	PAINT	
107	STAFF DOG BATHING	1	3'-0"	7'-0"	1 3/4"	C	STEEL	TEMP	PAINT	HM	PAINT	7, 11
108	MEN'S RESTROOM	4	3'-0"	7'-0"	1 3/4"	D	STEEL	-	PAINT	HM	PAINT	
109	WOMEN'S RESTROOM	4	3'-0"	7'-0"	1 3/4"	D	STEEL	-	PAINT	HM	PAINT	
110	RESTROOM	4	3'-0"	7'-0"	1 3/4"	G	STEEL	-	PAINT	HM	PAINT	
111	JANITOR	5	3'-0"	7'-0"	1 3/4"	D	STEEL	-	PAINT	HM	PAINT	
112	BREAK ROOM	5	3'-0"	7'-0"	1 3/4"	D	STEEL	TEMP	PAINT	HM	PAINT	
113	I.T.	4	3'-0"	7'-0"	1 3/4"	F	STEEL	-	PAINT	HM	PAINT	
114	OFFICE	2	3'-0"	7'-0"	1 3/4"	F	STEEL	-	PAINT	HM	PAINT	
115	OFFICE	5	3'-0"	7'-0"	1 3/4"	F	STEEL	-	PAINT	HM	PAINT	
116	TRAINING	2	3'-0"	7'-0"	1 3/4"	C	STEEL	TEMP	PAINT	HM	PAINT	


DOOR SCHEDULE NOTES:

1. PROVIDE INSULATION AND WEATHER STRIPING TO DOORS AND FRAMES BETWEEN WAREHOUSE AND CONDITIONED SPACES.
2. ALL INTERIOR HM DOOR AND WINDOW FRAMES TO BE PAINTED P-4 'CYBERSPACE'
3. ALL EXTERIOR HM DOORS TO BE PAINTED TO MATCH CMU
4. ALL HANDLES ARE LEVER TYPE
5. ELIASON DOOR EASY SWING HINGE SYSTEM, NSF MODEL HCG-10N; COLOR: GRAY
6. INSTALL DOOR SCOPE
7. COORDINATE ELECTRICAL REQUIREMENTS WITH OWNERS ACCESS CONTROL CONTRACTOR PRIOR TO INSTALLING FRAMES
8. PROVIDE KICK-DOWN DOOR STOP
9. PROVIDE 4" HEAD AT MASONRY OPENINGS
10. KEY CONTROL ON ALL AUTO DOORS SHOULD BE MOUNTED ON TOP OF AUTO DOORS
11. INSTALL DOME FLOOR STOP

ENERGY CODE NOTES:

1. AUTOMATIC STOREFRONT DOOR GLAZING TO MEET THE FOLLOWING REQUIREMENTS:
SHGC: 0.35
VT: 0.18
U-FACTOR: 0.35
FF: 3.00
2. ALUMINUM STOREFRONT GLAZING TO MEET THE FOLLOWING REQUIREMENTS:
SHGC: 0.35
VT: 0.18
U-FACTOR: 0.36
3. INSULATED METAL DOORS TO MEET THE FOLLOWING REQUIREMENTS:
U-FACTOR: 0.125



SEE COMCHECK FORMS FOR ADDITIONAL INFORMATION

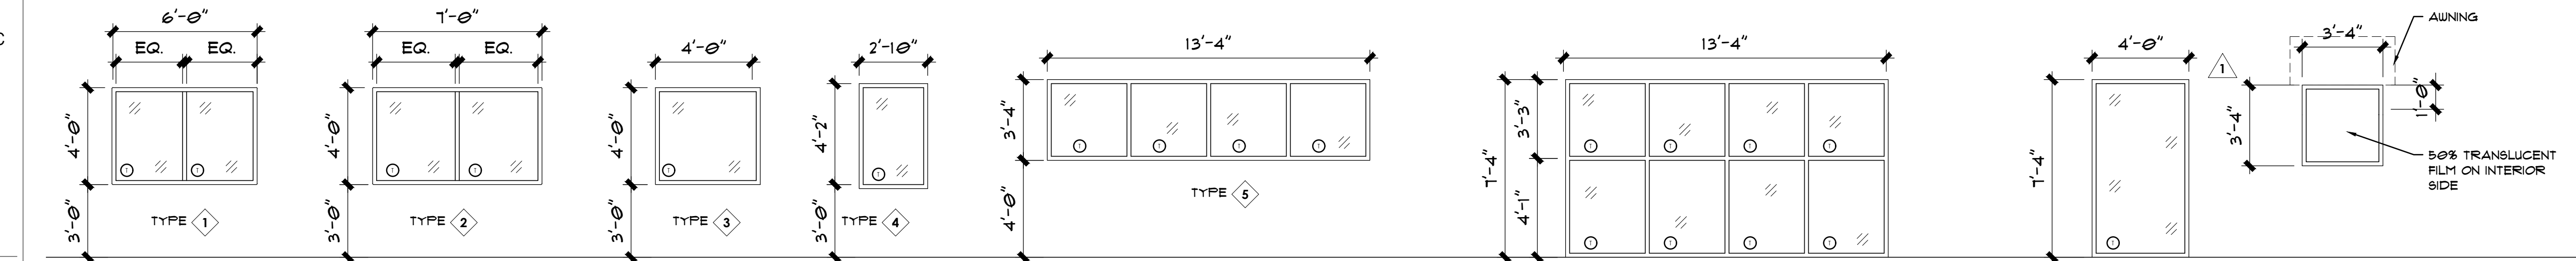

D1 WINDOW TYPES

SCALE: 1/4" = 1'-0"


NOTE: ALL GLASS TO BE TEMPERED

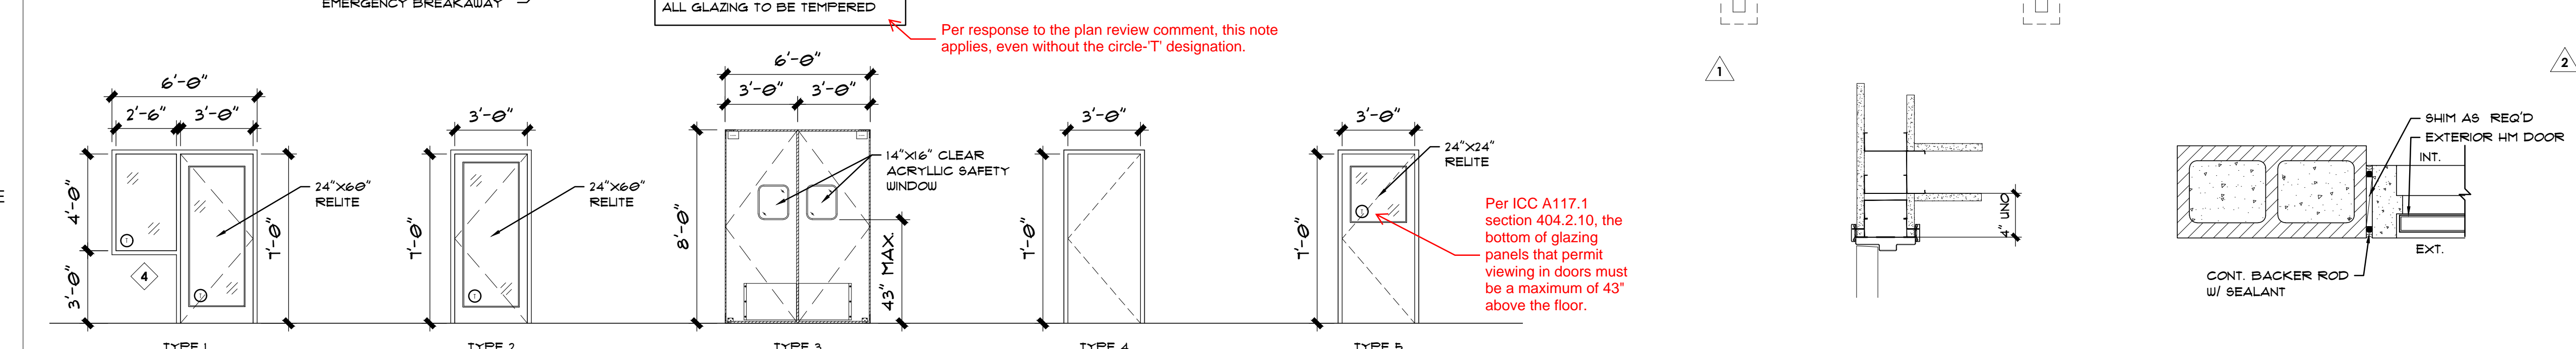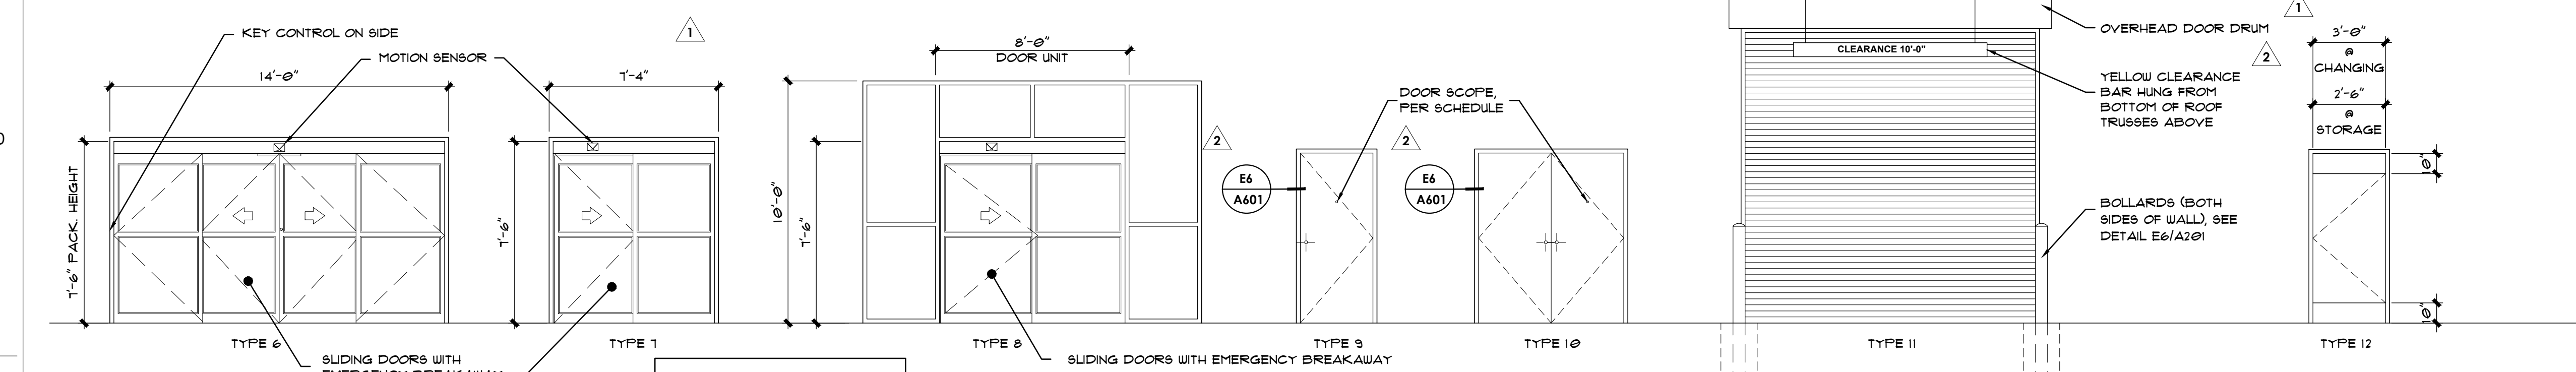

E1 DOOR TYPES

SCALE: 1/4" = 1'-0"

NOTE: ALL GLASS TO BE TEMPERED

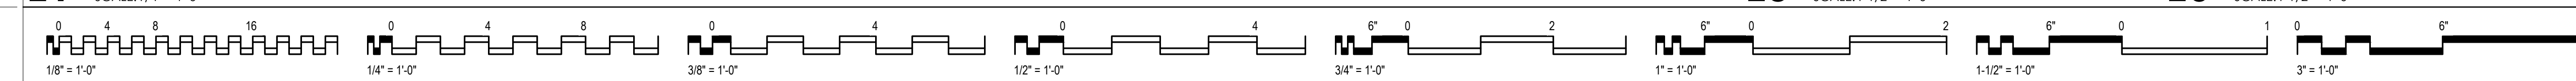

E5 TYP. DOOR JAMB

SCALE: 1-1/2" = 1'-0"

E6 TYP. DOOR JAMB

SCALE: 1-1/2" = 1'-0"

SHEET NOTES

NOVAK ARCHITECTURE INC.
8380 SW NYBERG ST.
SUITE B
TUALATIN, OR 97062
P 503.352.4987
www.novakarchitecture.com

Reviewed for Code Compliance - 08/18/2023 3:32:30 PM
Permit Number: 25-01679-01
Eugene

WILCO EUGENE
WILTH & WILLOW CREEK
EUGENE, OREGON 971402

WILCO
200 INDUSTRIAL WAY
MT. ANGEL, OR 97362

project number 18-25
date 10/03/22

revisions
1 06/02/23 AGENCY/QC REVIEW
2 07/06/23 TENANT REVIEW
3 08/01/23 PLAN REVIEW

REGISTERED ARCHITECT
4140
TERRY J. NOVAK
PORTLAND, OREGON
STATE OF OREGON

DOOR & WINDOW SCHEDULE

sheet number

A601

Received by City of Eugene: 07_A601 DOOR AND WINDOW SCHEDULE - 08/01/2023 10:24:41 AM